




1 TRANSITION DETAIL  
SCALE: FULL SCALE

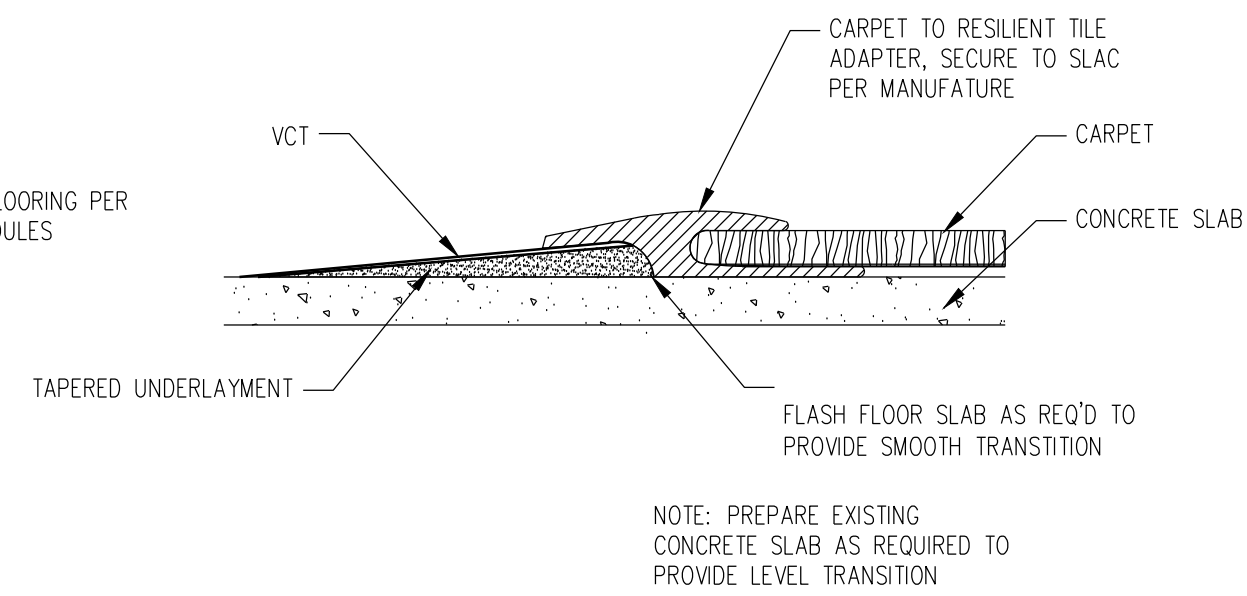

2 TRANSITION DETAIL  
SCALE: FULL SCALE

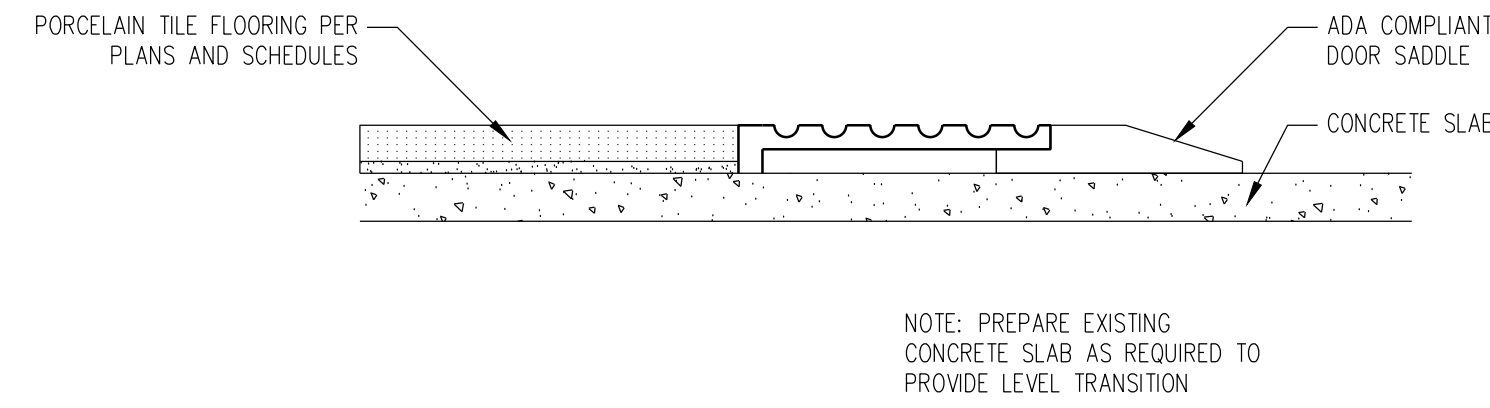


3 TRANSITION DETAIL  
SCALE: FULL SCALE

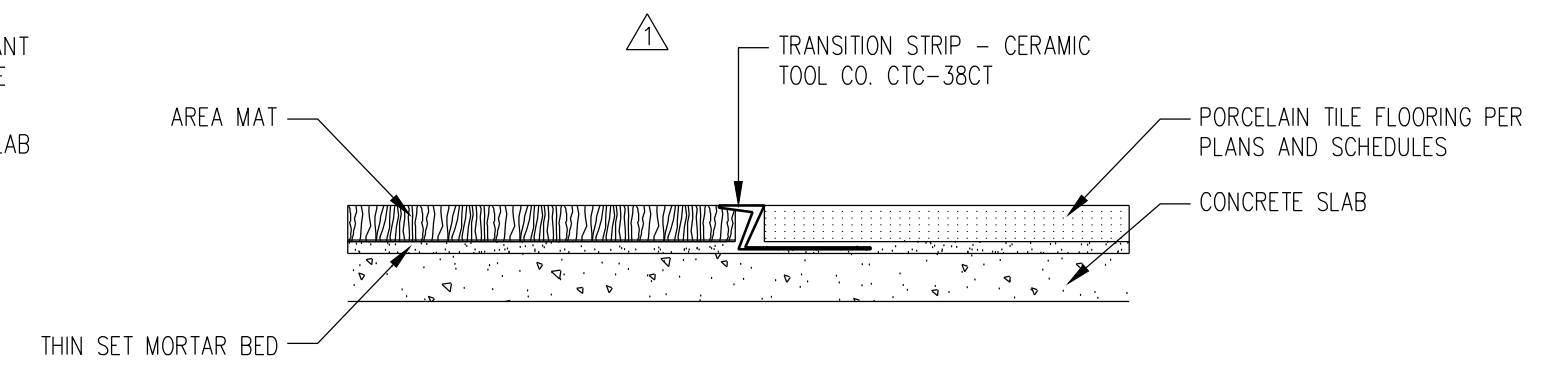

4 TRANSITION DETAIL  
SCALE: FULL SCALE

FLOOR FINISH PLAN KEY NOTES:

- 1 ENTRY MAT
- 2 GC TO FURNISH AND INSTALL FLOORING - SEE ROOM / FINISH SCHEDULE.
- 3 EXISTING FLOORING TO REMAIN.

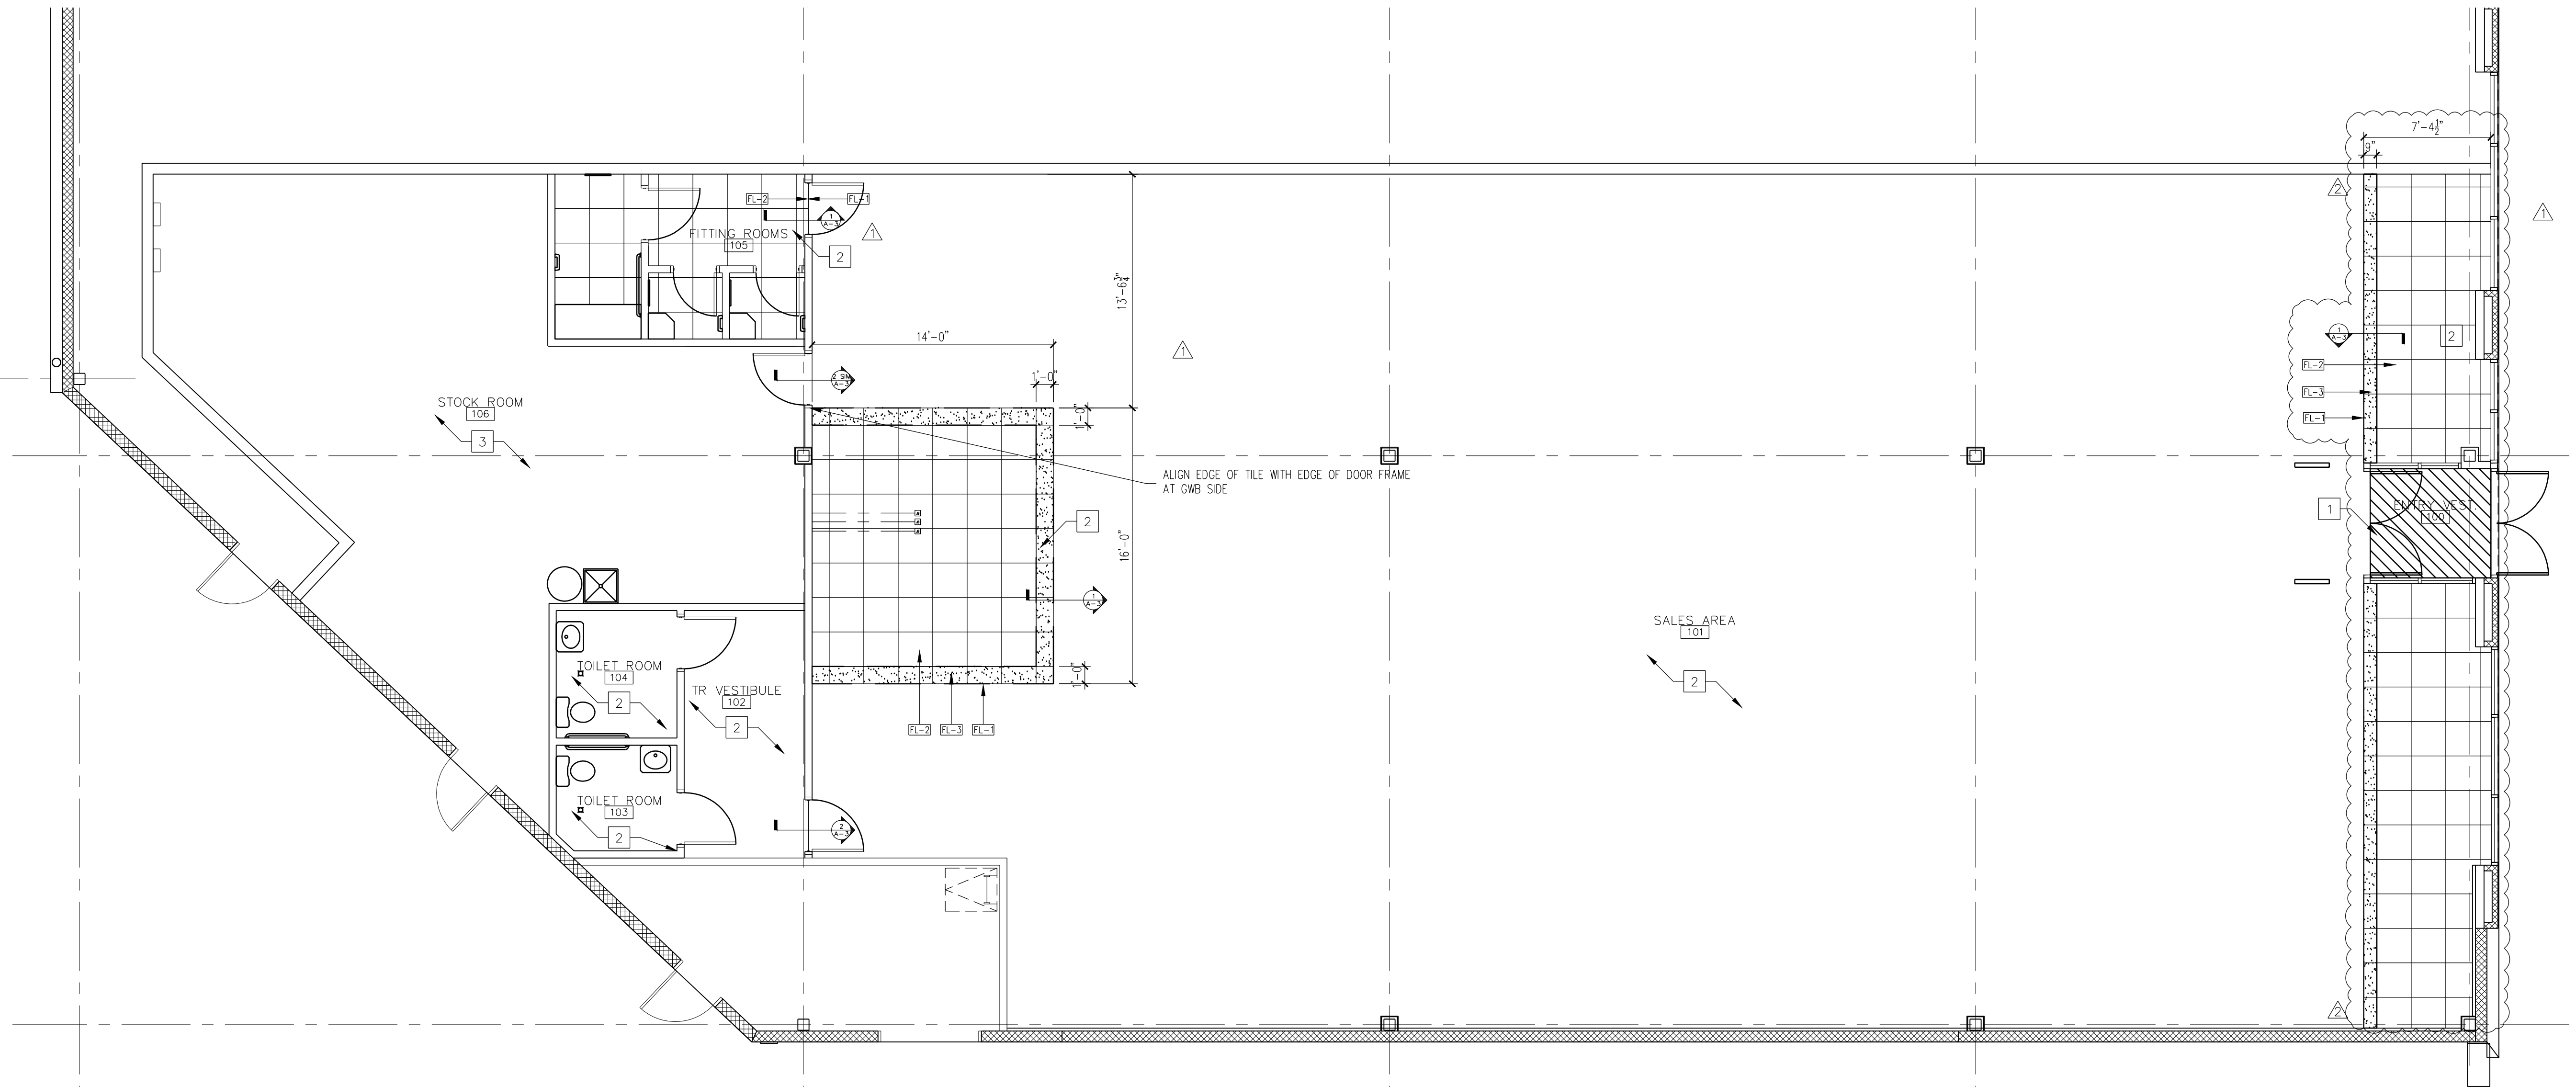

5 FLOOR FINISH PLAN  
SCALE: 3/16" = 1'-0"

NO.	DESCRIPTION	DATE
1	TENANT COMMENTS	5/03/12
2	PLAN REVIEW	4/16/12
3	ISSUE FOR PERMIT	03/26/12
4		
5		
6		
7		
8		
9		
10		

ALL FIELD CONDITIONS AND DIMENSIONS ARE TO BE FIELD VERIFIED PRIOR TO COMMENCEMENT OF THE WORK. ALL DISCREPANCIES ARE TO BE BROUGHT TO THE ATTENTION OF THE ARCHITECT BEFORE PROCEEDING WITH THE WORK. THESE DRAWINGS ARE THE PROPERTY OF JOHN WILLIAM LISTER ARCHITECT. THEY ARE NOT TO BE REPRODUCED IN PART OR IN WHOLE WITHOUT THE CONSENT OF JOHN WILLIAM LISTER ARCHITECT. THEY ARE TO BE USED ON THE PROJECT NOTED HEREON ONLY.

**RAINBOW**  
LANDLORD WORK  
#161 COOPER TOWNE  
CENTER  
711 EVESHAM ROAD  
SOMERDALE, NJ 08083

SHEET TITLE		SHEET NUMBER	
FLOOR FINISH PLAN		A-3	
3/19/2012	DATE		
AS NOTED	SCALE		
JAS	DRAWN BY		
JWL	CHECKED BY		
12-012	PROJECT #		

